




Existing Covered Storage Area: Front Elevation
1:100@A1

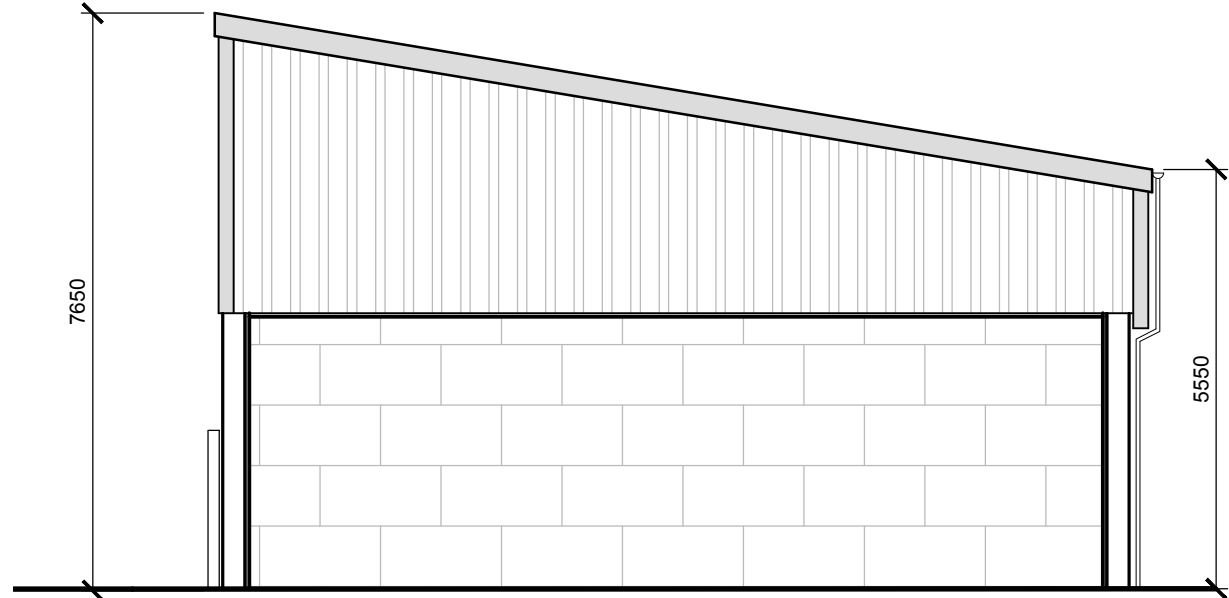

Existing Covered Storage Area: Side Elevation
1:100@A1

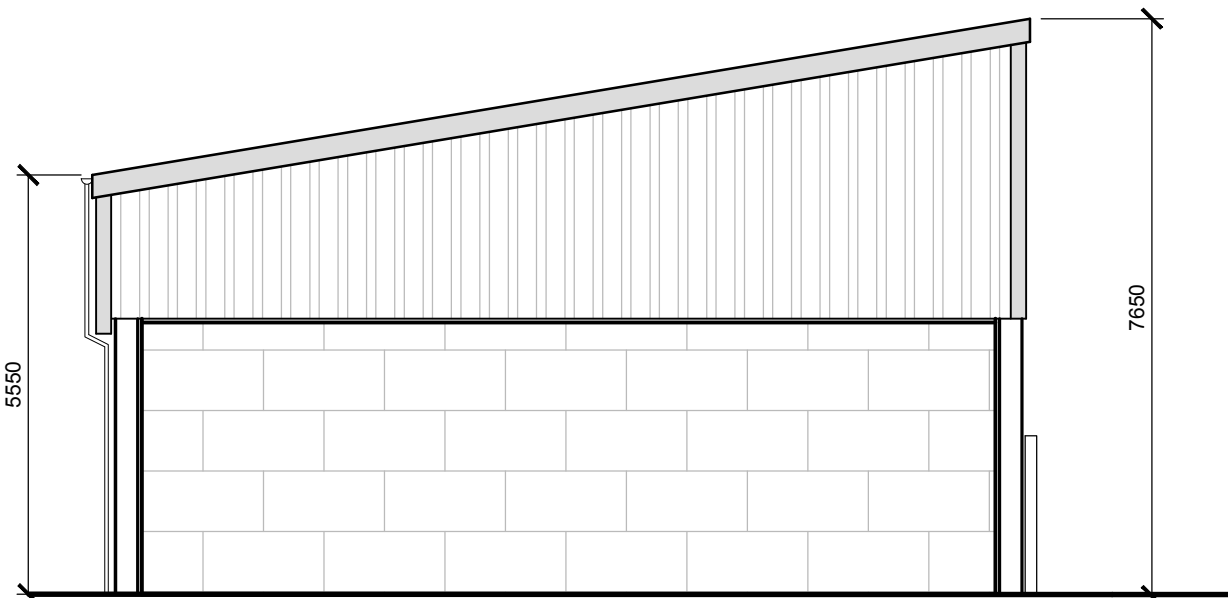

Existing Covered Storage Area: Side Elevation
1:100@A1

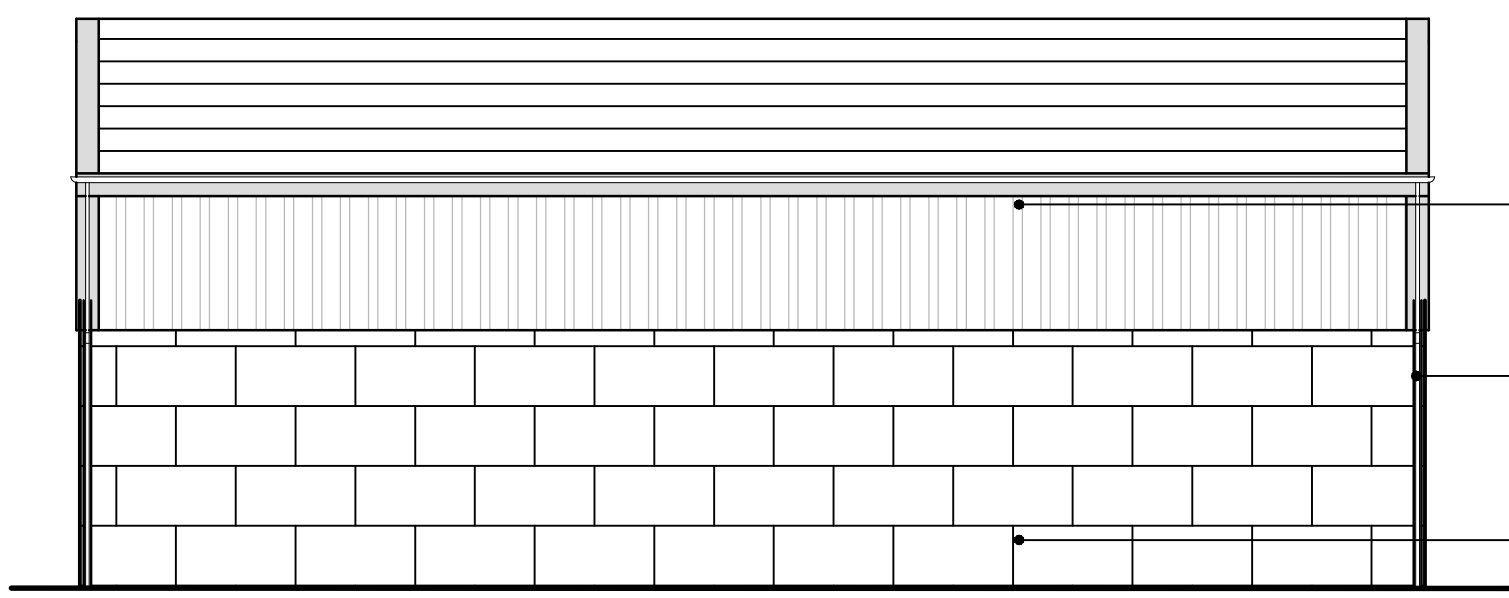

Existing Covered Storage Area: Rear Elevation
1:100@A1


Profile
Metal
Cladding

Grey UPVC
gutters /
Down pipes


Block
Walling

Side


Side

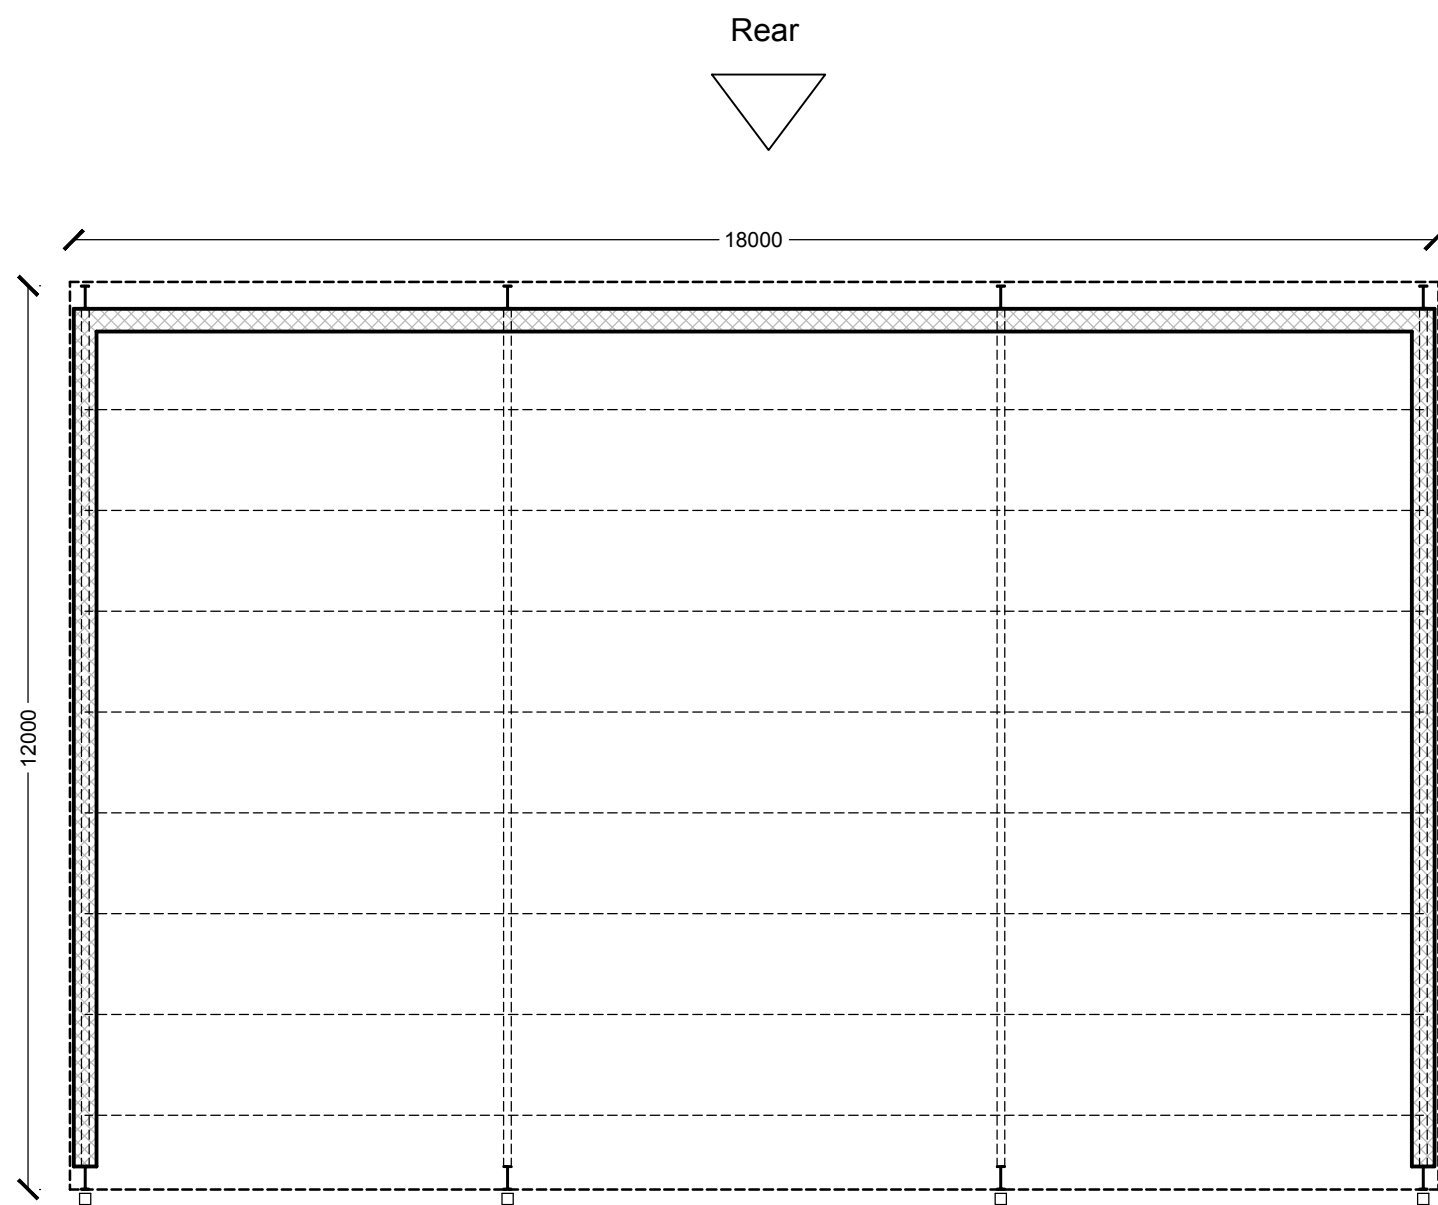


Existing Covered Storage Area: Floor Plan
1:100@A1

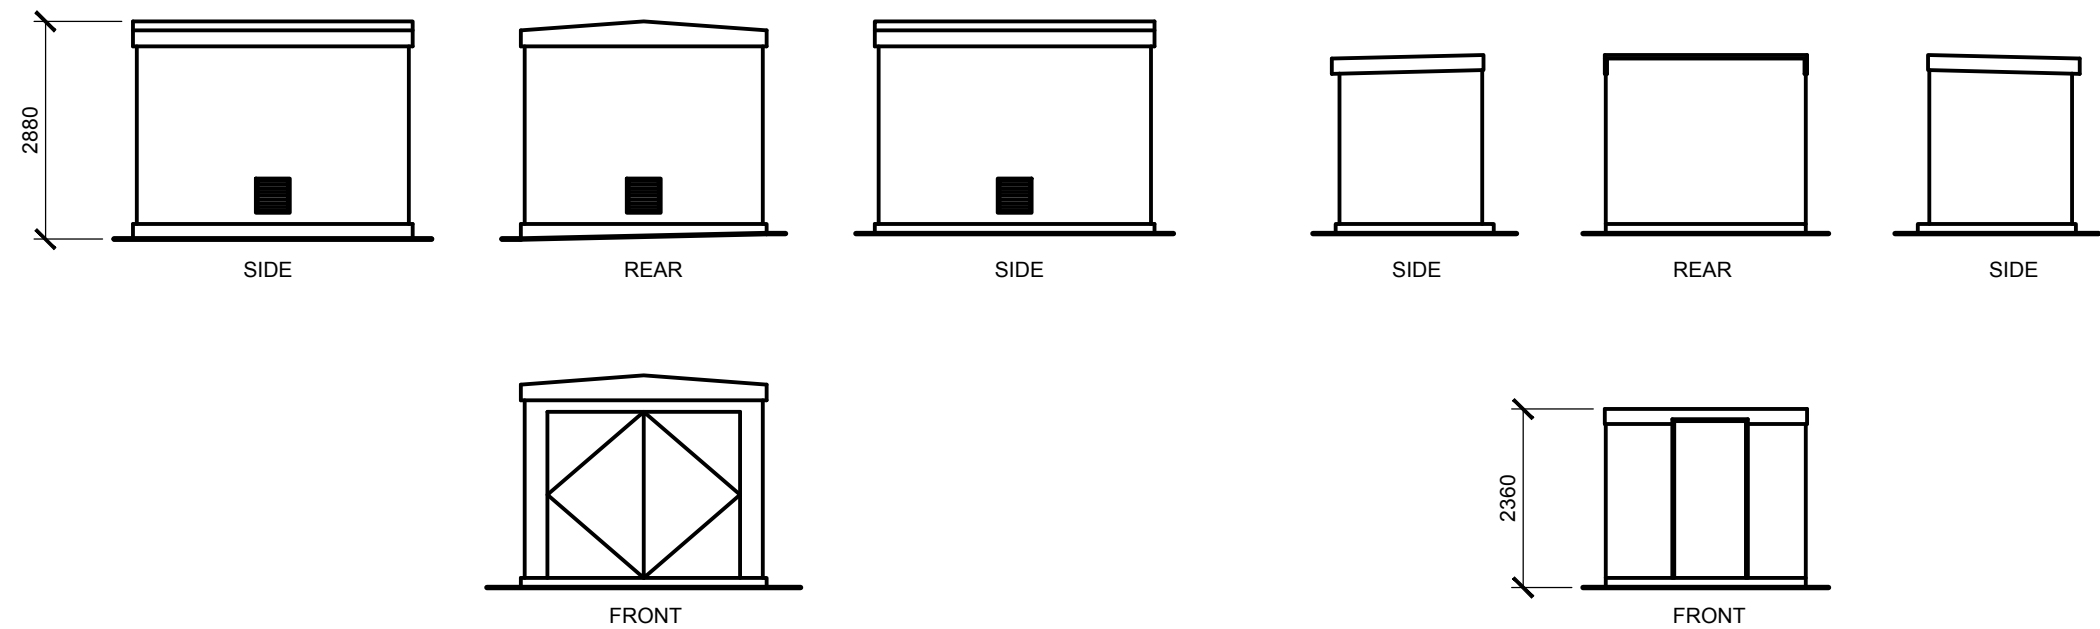


Existing Sub-station & Meter Room: Elevations
1:100@A1

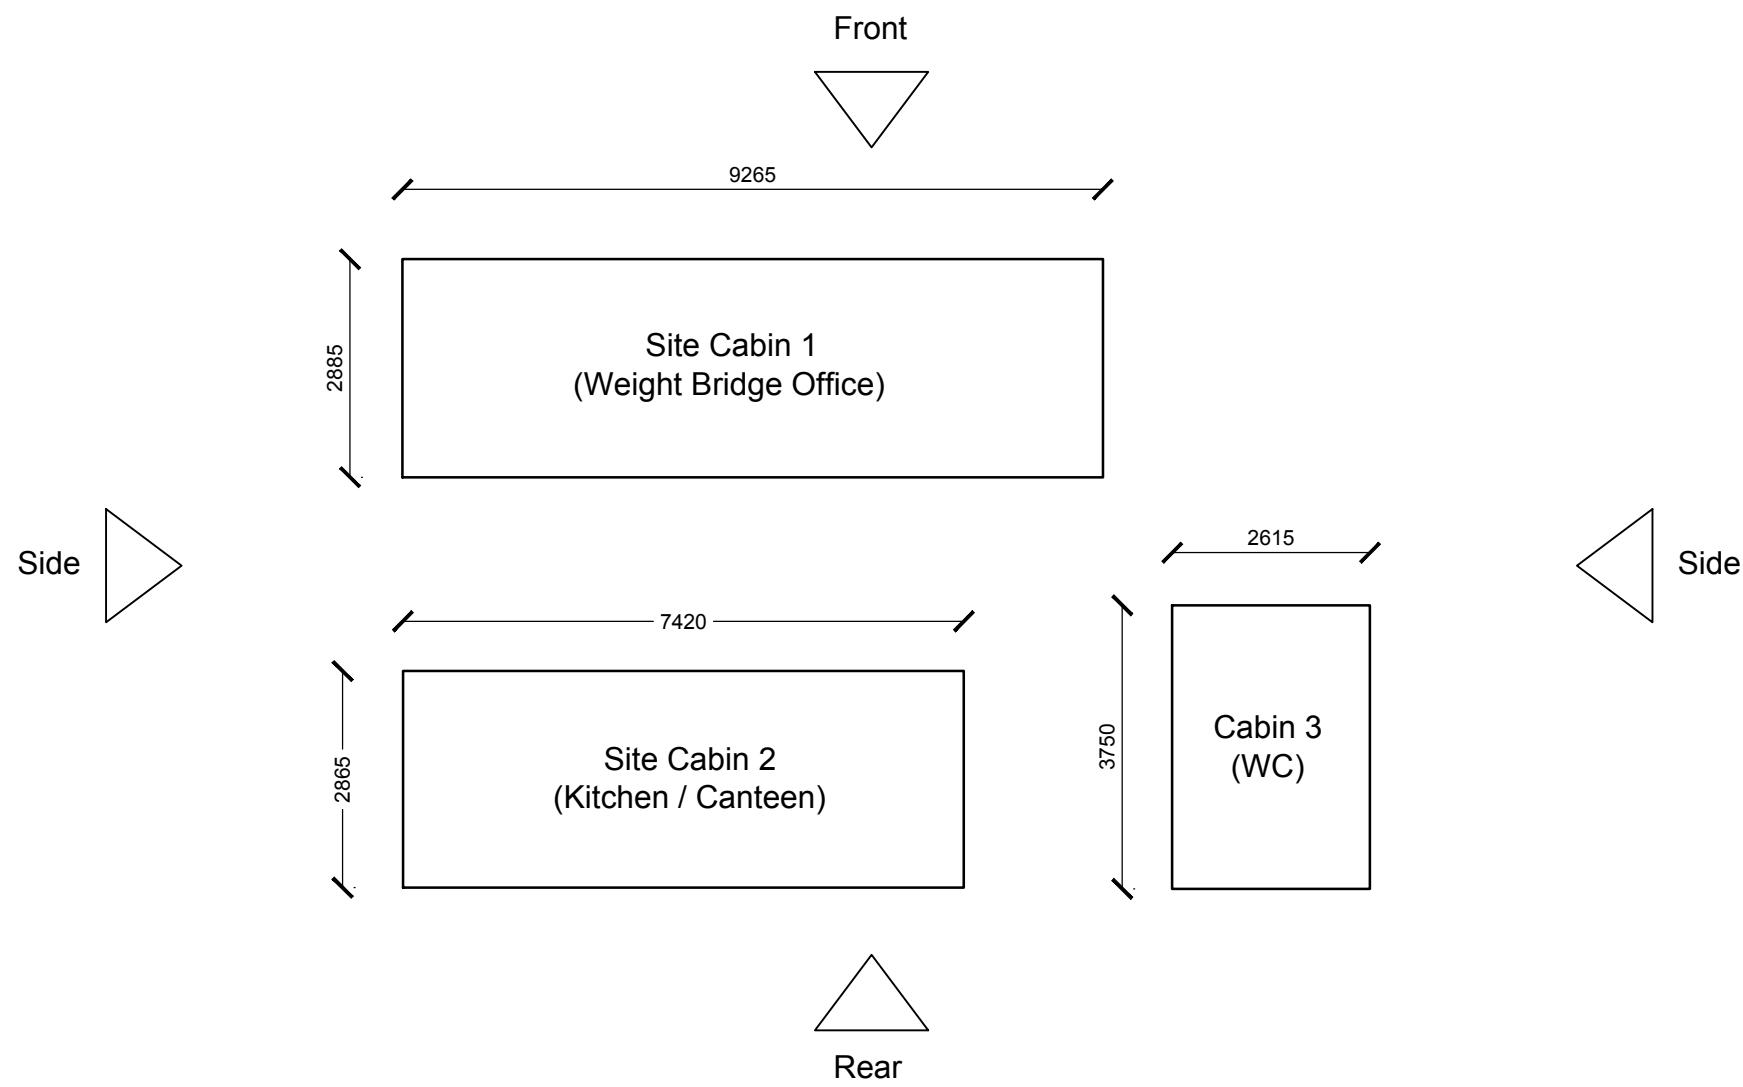


Existing Site Cabins: Floor Plan
1:100@A1

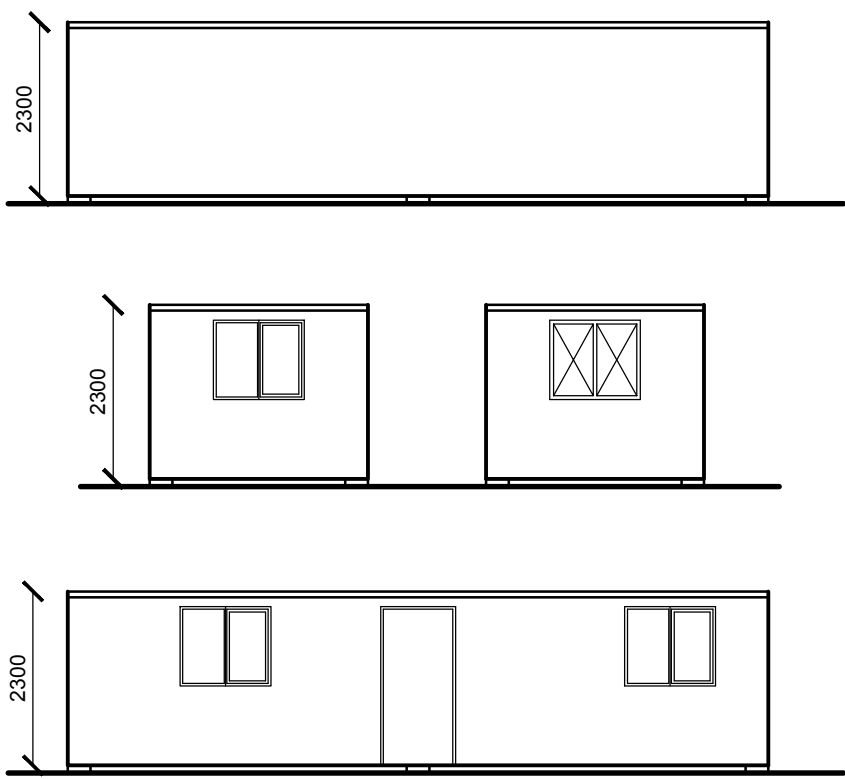

Existing Site Cabin 1 : Elevation(s)
1:100@A1

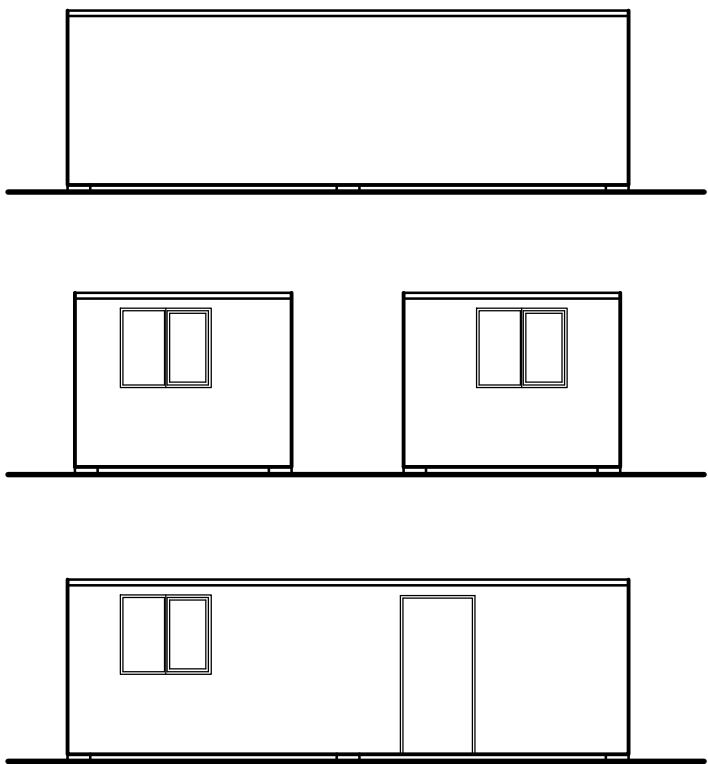

Existing Site Cabin 2: Elevation(s)
1:100@A1

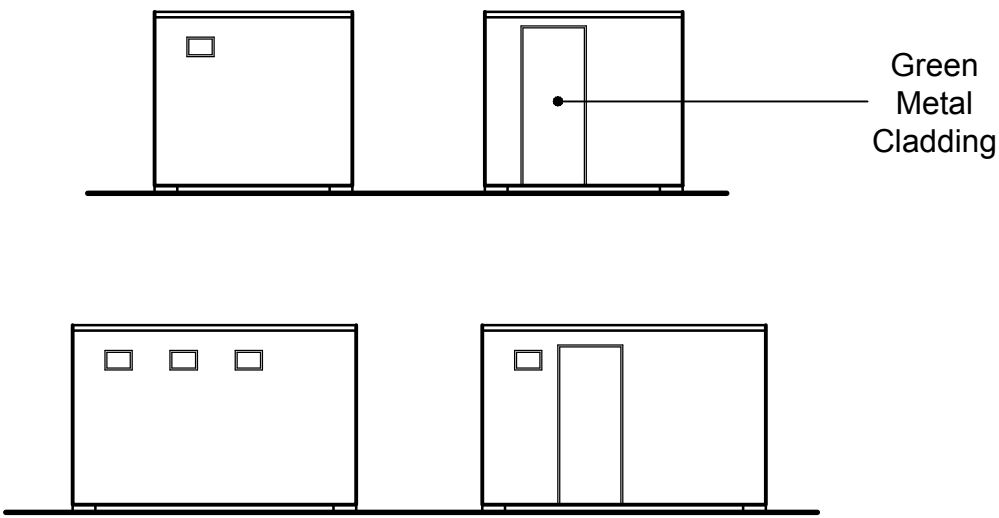

Existing Site WC: Elevation(s)
1:100@A1

Green
Metal
Cladding

Side

Side

NOTES:
Copyright in all documents prepared by the architect and any works executed from these documents and drawings, shall unless otherwise agreed, remain the property of the architect and must not be reproduced by, lent or disclosed to, a third party without the written consent of Good and Tillotson.

DO NOT SCALE OFF THIS DRAWING.
All dimensions to be checked on site and any discrepancies to be referred to the architect before proceeding.

ALL LEVELS TO BE CHECKED ON SITE.
All discrepancies between information shown on the drawings and the information in the specification to be referred to the architect before proceeding.

All component sizes and references to be checked prior to the ordering of materials.

Positions and designation (i.e. combined, surface water or foul) of existing drain runs on site are to be checked / confirmed by the building contractor prior to commencement of any drainage works. Any existing drains, to which additional connections are to be made, are also to be checked as necessary to ensure they are suitable to accommodate additional capacity and the type of effluent being connected.

All relevant boundary positions are to be checked prior to proceeding.

Rev	Revision	Int.	Date
Client:			
Saica Natur			
Project:			
Retrospective application for covered shelter / Storage building & Site cabins.			
Location:			
York street Audenshaw Manchester M34 5TN			
Good & Tillotson Chartered Architects			
2 The Studios, 318 Chorley Old Road, Bolton, BL1 4JU			
Tel: 01204 497700			
Email : info@goodandtillotson.co.uk			
Web: www.goodandtillotson.co.uk			
Drawing Title:			
Existing Elevations & Plans (As Built)			

G&T Job No:	Scale:	Drawn:	Checked:	Date:
2115	1:100@A1			29.03.21
Drawing Purpose:	Status:	Revision:		
PLANNING				
BIM Project:	Origin:	Zone:	Level:	Type:
2115-G&T-Z0-00-DR-A-1002				